

AS BUILT FLOOR PLAN

1/4" = 1'-0"

REVISIONS	DATE

Design o Tech Associates  
*professional design services*

488 BLACK AVENUE, SUITE 250 • PLEASANTON, CA 94666  
 PH: (925) 223-6200


OWNER:  
**JEN & GEORGE SCHMITT**  
 554 HAMILTON WAY  
 PLEASANTON, CA

PROJECT LOCATION:  
**SCHMITT**  
**ADDITION/REMODEL**  
 554 HAMILTON WAY  
 PLEASANTON, CA

DRAWING TITLE:  
**AS BUILT**  
**FLOOR PLAN**


DRAWN	SBF
CHECKED	GLMMH
DATE	03/20/14
SCALE	AS NOTED
JOB NO.	14-002
SHEET	

**AB.1**

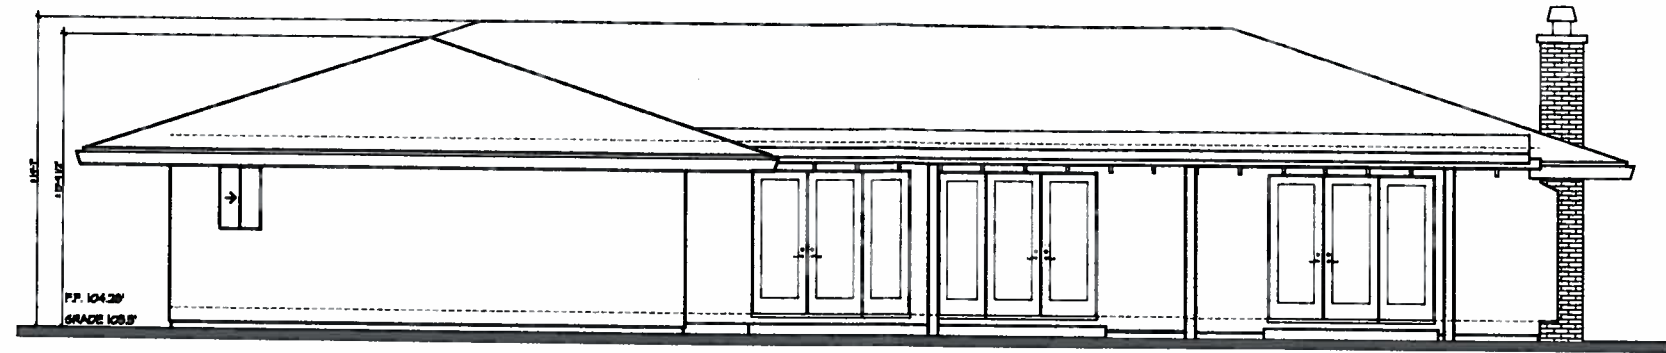


REAR ELEVATION

1/4" = 1'-0"

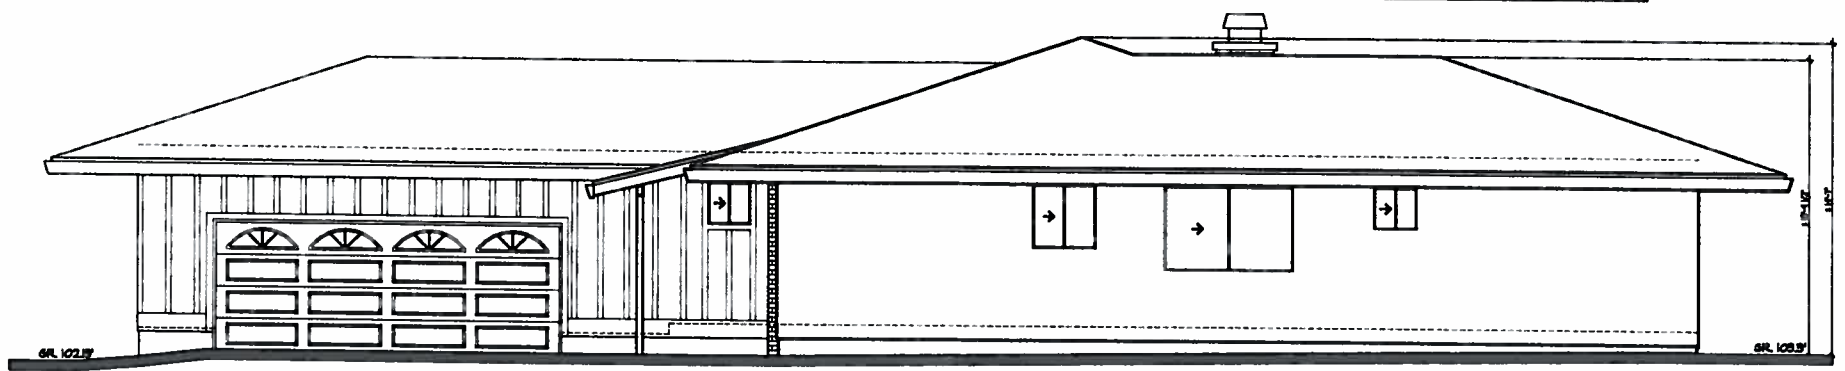

RIGHT ELEVATION

1/4" = 1'-0"

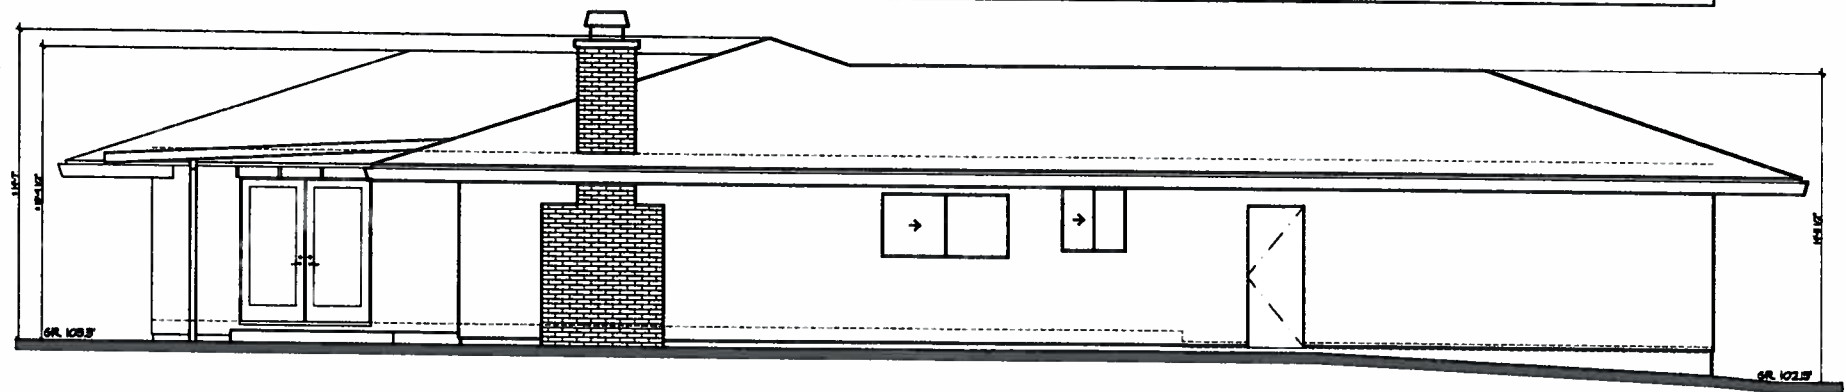

LEFT ELEVATION

1/4" = 1'-0"



FRONT ELEVATION

1/4" = 1'-0"

REVISIONS	DATE

Design & Tech Associates  
Professional Design Services

4458 BLACK AVENUE, SUITE 250 • PLEASANTON, CA 94566  
PH: (925) 223-4200

OWNER:  
**JEN & GEORGE SCHMITT**  
554 HAMILTON WAY  
PLEASANTON, CA 94566


PROJECT LOCATION:  
**SCHMITT**  
**ADDITION/REMODEL**  
554 HAMILTON WAY  
PLEASANTON, CA 94566

DRAWING TITLE:  
**AS BUILT**  
**ELEVATIONS**

DRAWN  
SRN  
CHECKED  
CLM/JM  
DATE  
10/01/14  
SCALE  
AS NOTED  
JOB NO.  
14-002  
SHEET


**AB.2**



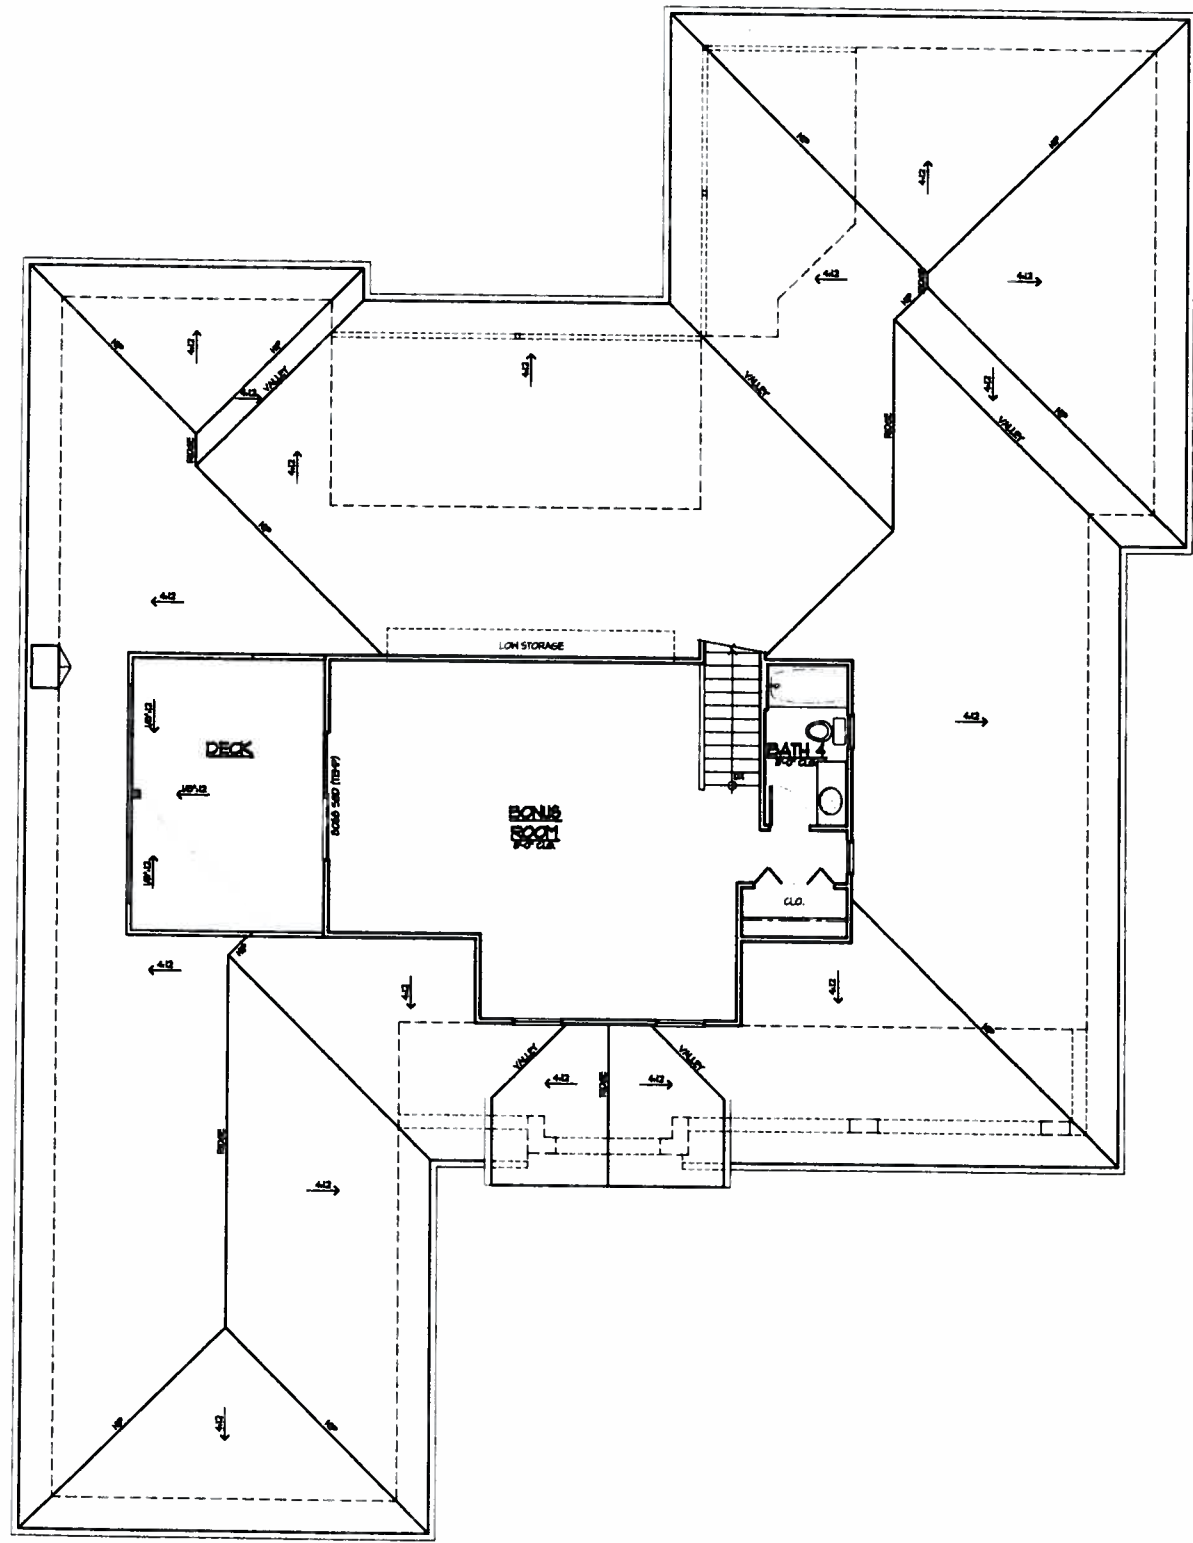

PROPOSED LOFT FLOOR PLAN

3/16" = 1'-0"

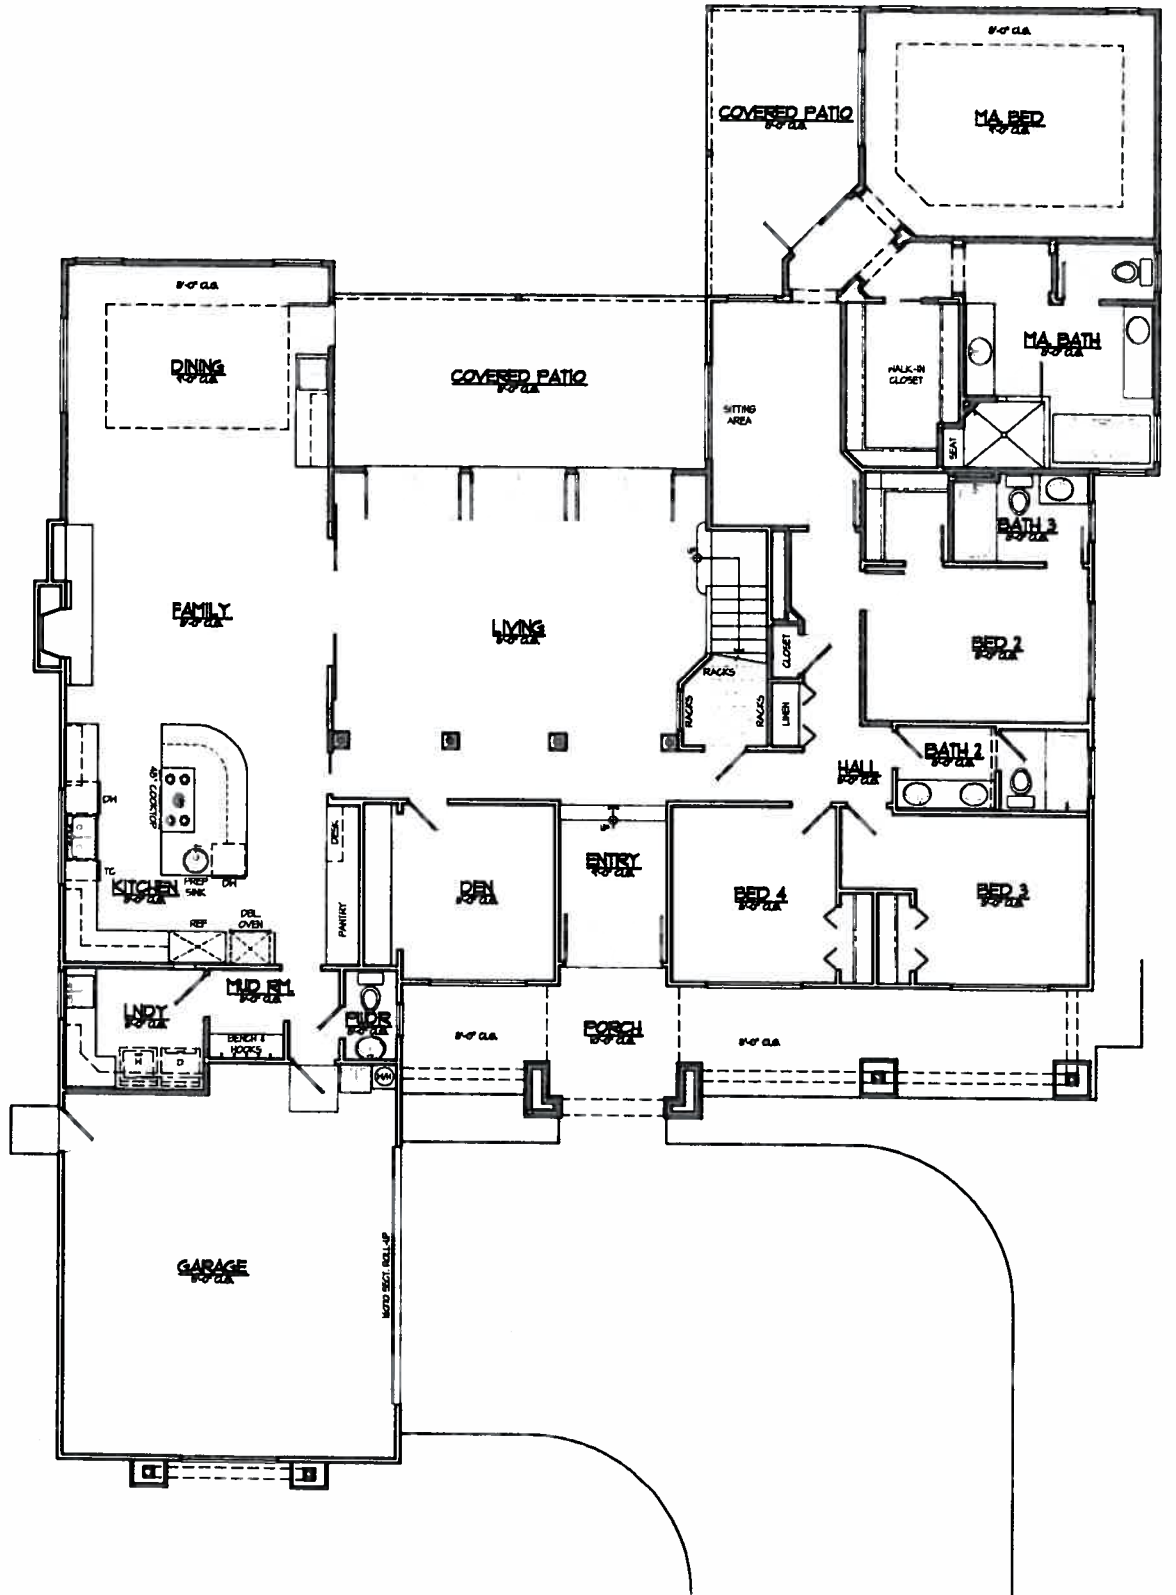

PROPOSED FLOOR PLAN

3/16" = 1'-0"

REVISIONS	DATE

Design & Tech Associates  
*professional design solutions*  
 448 BLACK AVENUE, SUITE 200 • PLEASANTON, CA 94566  
 PH: (925) 724-6200


OWNER:  
**JEN & GEORGE SCHMITT**  
 554 HAMILTON WAY  
 PLEASANTON, CA 94566

PROJECT LOCATION:  
**SCHMITT**  
**ADDITION/REMODEL**  
 554 HAMILTON WAY  
 PLEASANTON, CA 94566


DRAWING TITLE:  
**PROPOSED**  
**FLOOR PLANS**

DRAWN  
 SBR  
 CHECKED  
 GJMUN  
 DATE  
 10/01/14  
 SCALE  
 AS NOTED  
 JOB NO.  
 14-002  
 SHEET


**A1.1**

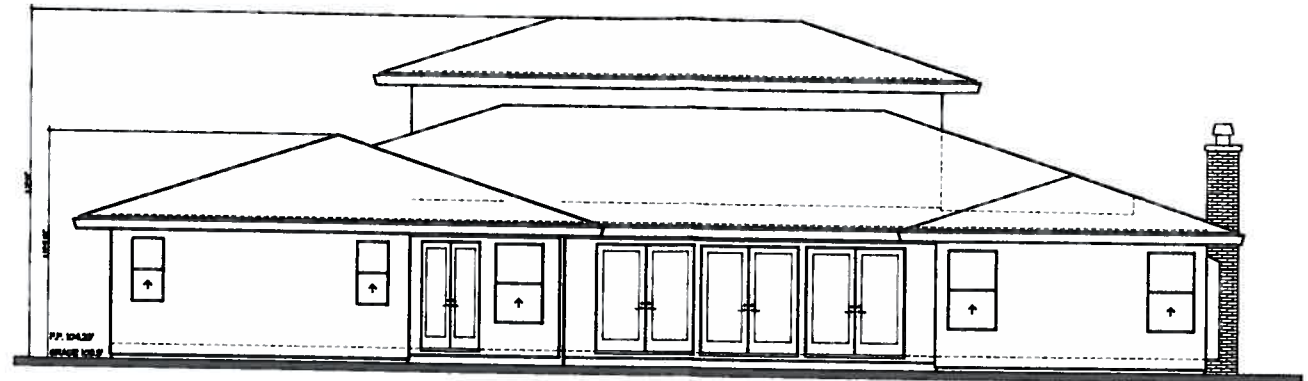

REAR ELEVATION 3/16" = 1'-0"

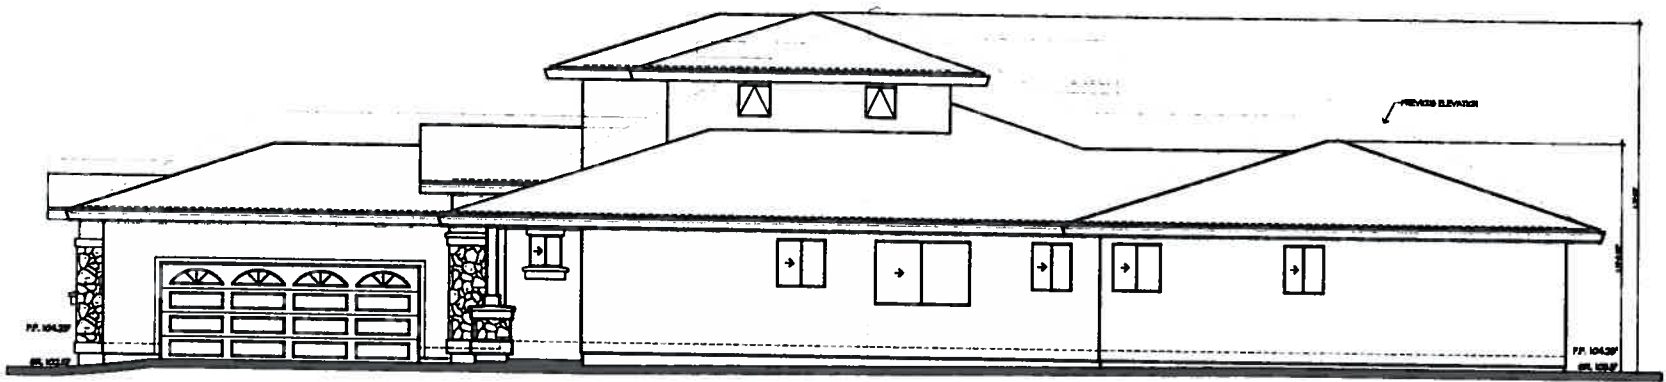

RIGHT ELEVATION 3/16" = 1'-0"

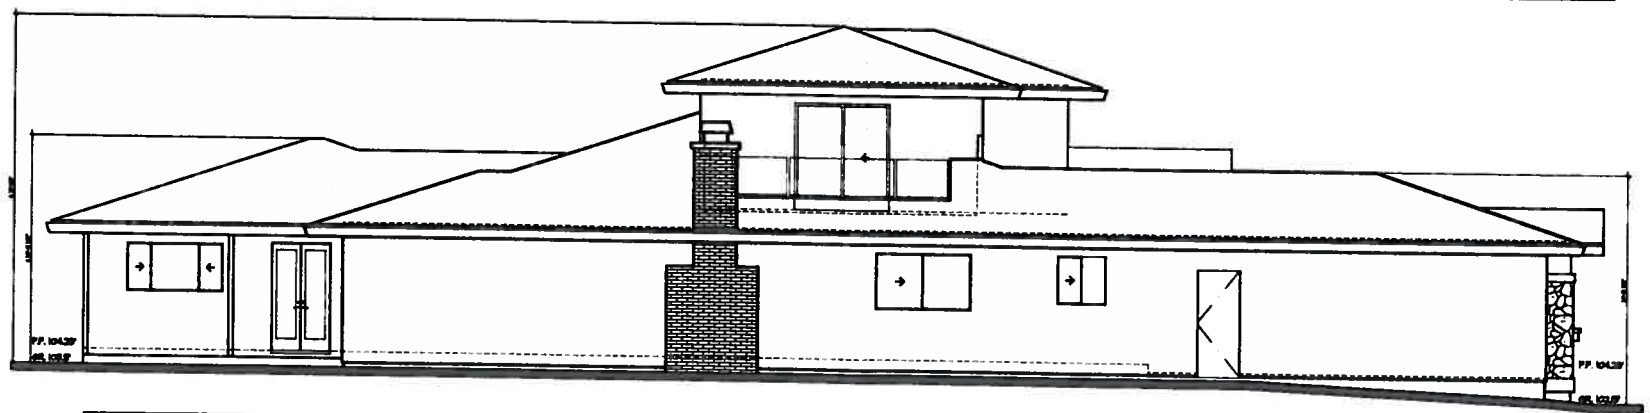

LEFT ELEVATION 3/16" = 1'-0"



FRONT ELEVATION 3/16" = 1'-0"

REVISIONS	DATE

Design & Tech Associates  
 Professional Design Services  
 4458 BLACK AVENUE, SUITE 250 • PLEASANTON, CA 94566  
 PH: (925) 723-8200

OWNER:  
**JEN & GEORGE SCHMITT**  
 554 HAMILTON WAY  
 PLEASANTON, CA 94566

PROJECT LOCATION:  
**SCHMITT**  
 ADDITION/REMODEL  
 554 HAMILTON WAY  
 PLEASANTON, CA 94566

DRAWING TITLE:  
**PROPOSED ELEVATIONS**

DRAWN  
 SER  
 CHECKED  
 CLM/UM  
 DATE  
 10/01/14  
 SCALE  
 AS NOTED  
 JOB NO.  
 14-062  
 SHEET

**A1.2**